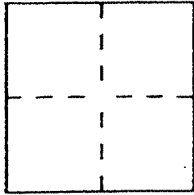


CORNER RECORD

Document Number APN 34-012-53City of TiburonCounty of Marin, CaliforniaBrief Legal Description Parcel 7, Ring Mountain Parcelization, 19 RM 29

CORNER TYPE

Government Corner ☐ Control ☐
Meander ☐ Property ☐
Rancho ☐ Other ☐
Date of Survey May 20, 2003

COORDINATES (Optional)

N. _____
E. _____
Zone _____ Datum _____
Elev. _____

Corner — Left as found ☐ Found and tagged ☐ Established ☒ Reestablished ☐ Rebuilt ☐

Identification and type of corner found: Evidence used to identify or procedure used to establish or reestablish the corner:

Found standard street monuments on the centerline of Via Los Altos
per 19 RM 29.

A description of the physical condition of the monument as found and as set or reset:

Set 3/4" I.P. and tag RCE 18221 unless shown otherwise on Exhibit A

SURVEYOR'S STATEMENT

This Corner Record was prepared by me or under my direction in conformance with
the Land Surveyors' Act on JULY 16, 2003 ~~19~~.

Signed [Signature] L.S. ~~or R.C.E.~~ Number 4522





COUNTY SURVEYOR'S STATEMENT

This Corner Record was received JULY 21, 2003 ~~19~~ and examined
and filed JULY 28, 2003 ~~19~~.

Signed [Signature] Title COUNTY SURVEYOR



County Surveyor's Comment _____

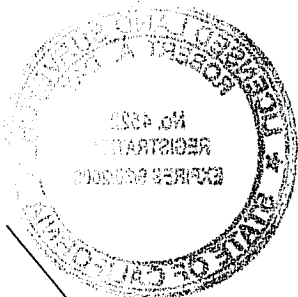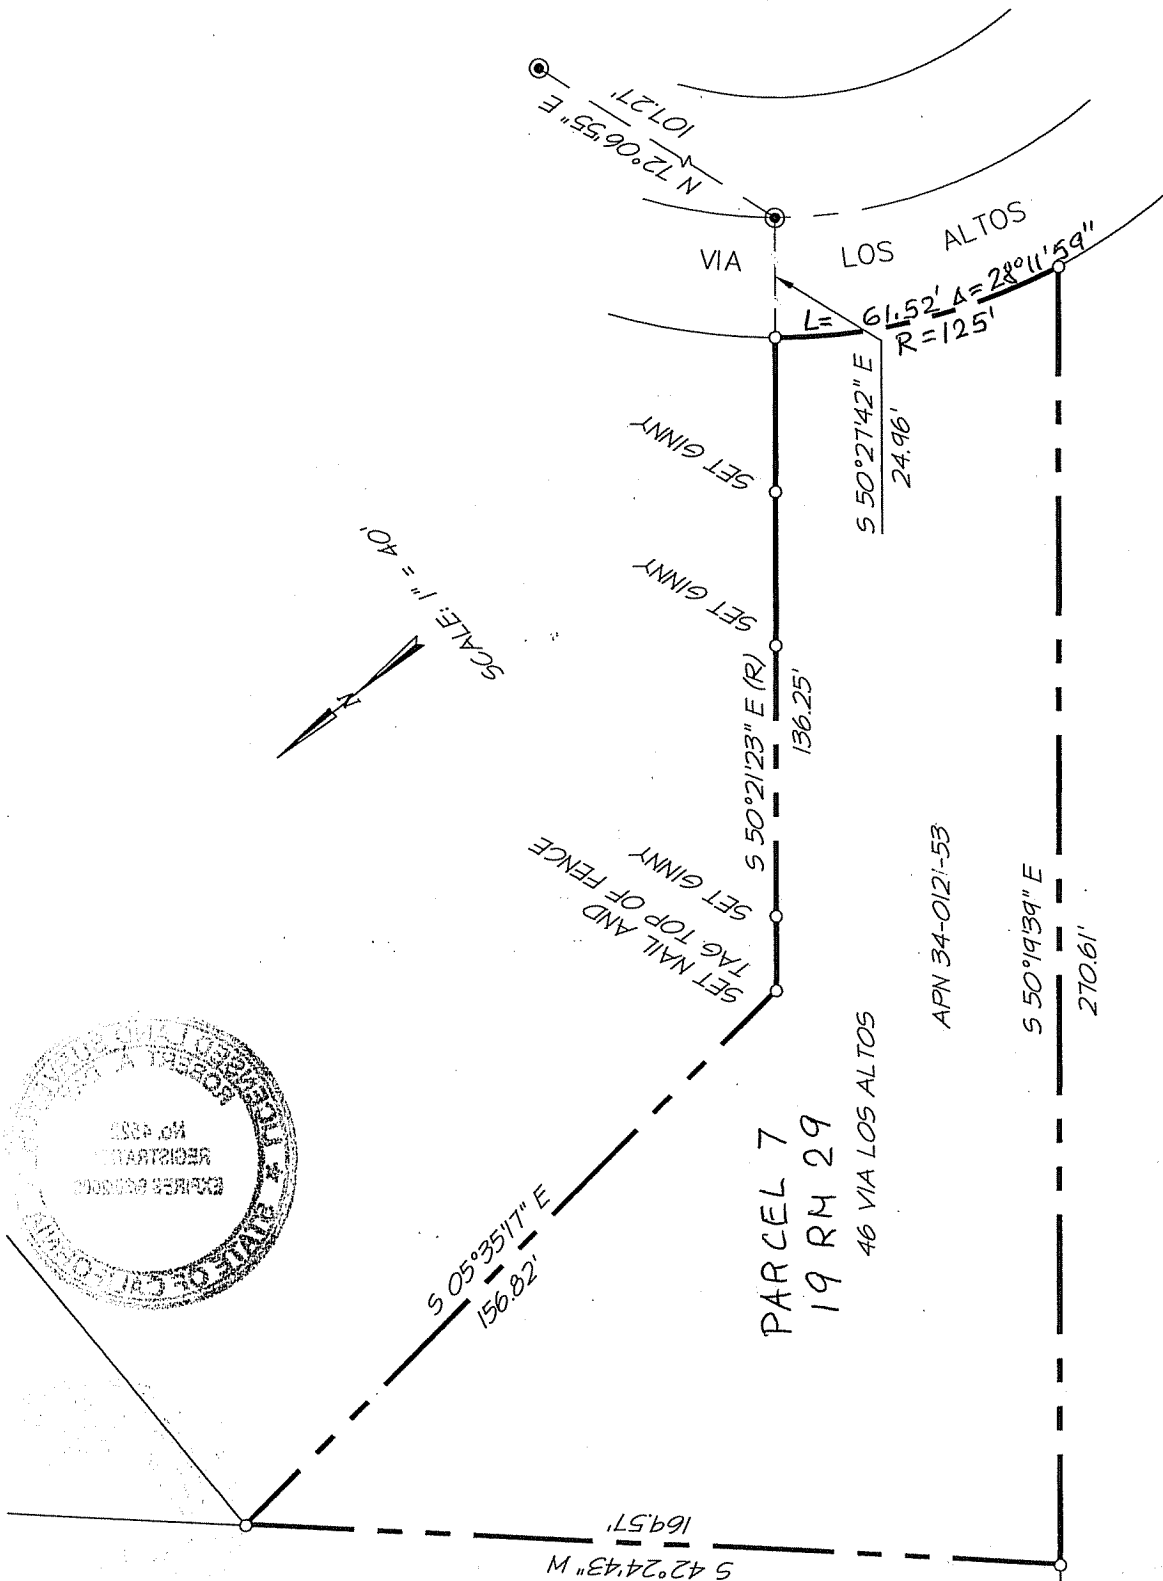

SCALE: 1" = 40'
N

EXHIBIT "A"

LEGEND

NOTE:

- FOUND STANDARD STREET MONUMENT ALL DIMENSIONS SHOWN HEREON ARE PER 19 RM 29 UNLESS OTHERWISE NOTED.
- SET 3/4" IRON PIPE & TAG "R.C.E. 18221" UNLESS NOTED OTHERWISE

ILS ASSOCIATES, INC.®
CIVIL ENGINEERING AND LAND SURVEYING



79 GALLI DRIVE, SUITE A NOVATO, CA 94945-5717 (415)853-9200 FAX (415)853-2753

A.P.N. 34-0121-53

DATE: 07/14/03
FILE: 7258C\FEC1.DWG